

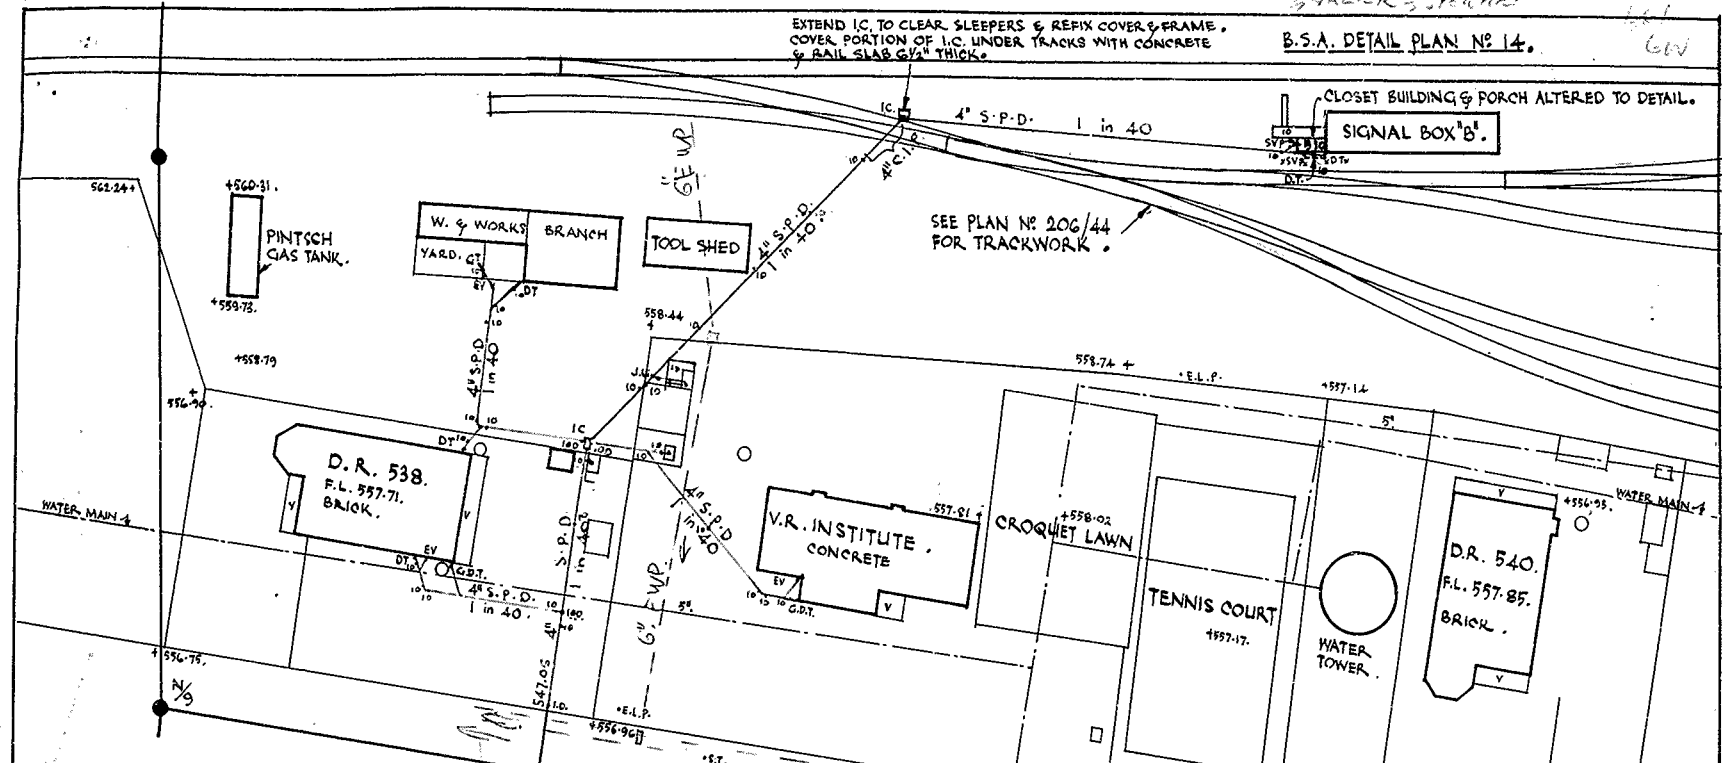


BARKER & STEWART
 B.S.A. DETAIL PLAN NO 14.

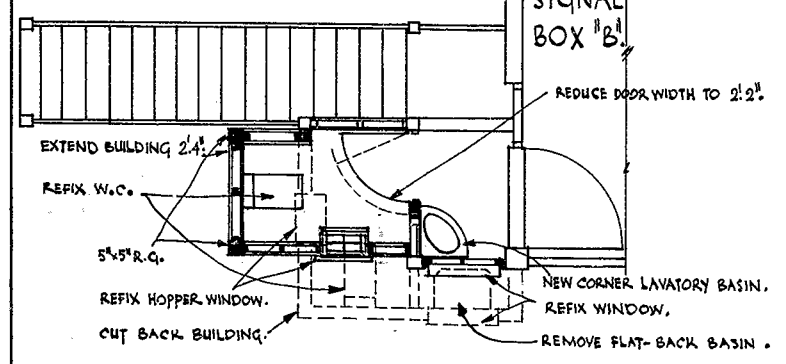

SEWERAGE PLAN
 SCALE : 40 FT. TO 1 INCH.

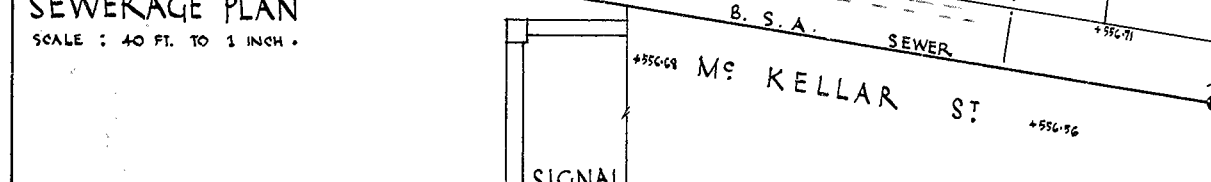

DETAIL PLAN
 SCALE : 4 FT. TO 1 INCH.

Completed

ADDITIONAL LIST OF FIXTURES.
 9. W.C. AT OPERATING LEVEL TO BE LOCATED IN NEW LAV. BASIN, " " " " POSITIONS AS PER DETAIL PLAN.

EXISTING DRAINS SHOWN IN GREEN.
 PROPOSED " " " " BLUE.
 S.V.P. & D.T. TO BE REFIXED IN POSITIONS SHOWN IN BLUE.

V.R.
BENALLA
 ALTERATIONS TO SIGNAL BOX "B", IN CONNECTION WITH RE-ARRANGEMENT OF TRACKS.
 SCALES AS SHOWN.

CHIEF CIVIL ENGINEER.
 WORK COMPLETED.
 DRAWN BY: C.A.N. R.R.O.
 CHECKED BY: C.A.N. R.R.O.
 COPIES: 6662/40
 S. 1817. D. 56.
 PLAN NO 585/44.
 26-3-1944

SEE SEWERAGE BY-LAWS.

1817
1817

