


PLAN No. 50593.
LITHO No. 1579.

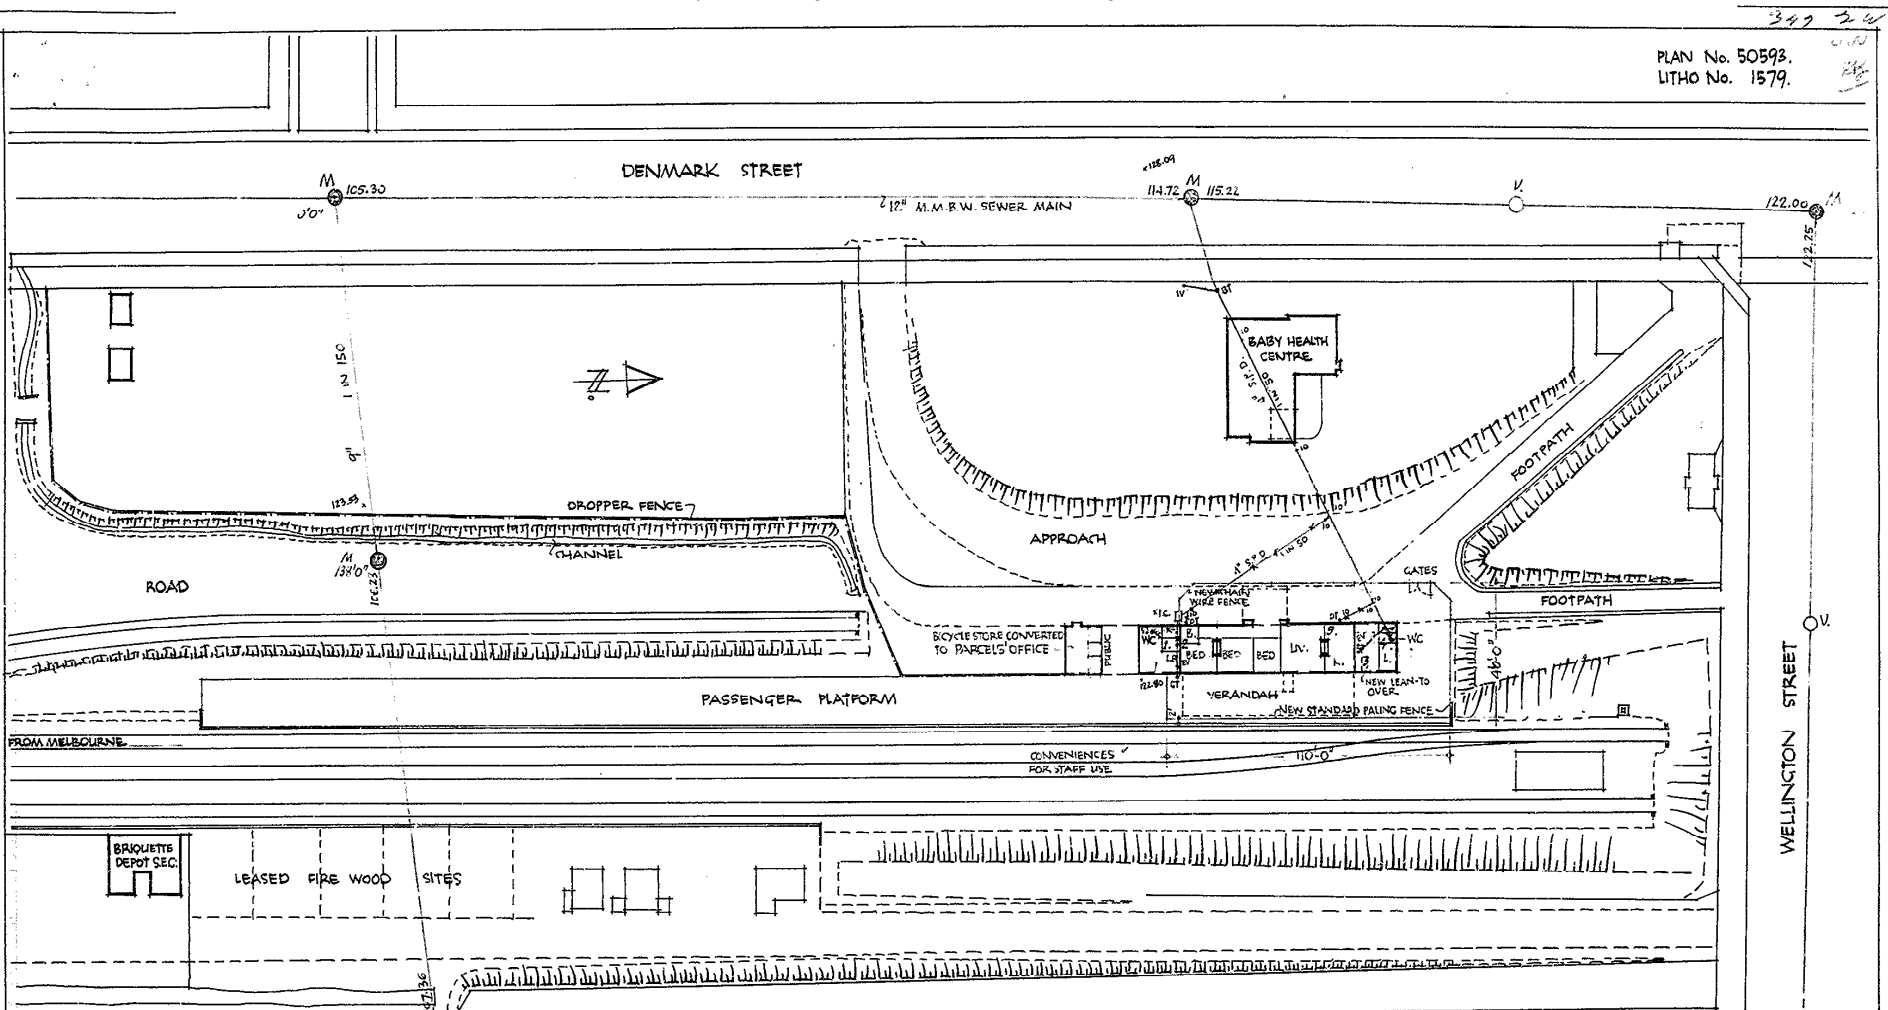

2220

LIST OF FITTINGS TO BE ABOLISHED.

1. Closets, 2nd ladies to be abolished,
 2. Lavatory basin, " " "
 3. Closets, " " " "
 4. Closets, 2nd mens, " " "
 5. Lavatory basin, " " "
- Drawings shown in green, crossed in blue to be cut & sealed at all ends & O.B.F.

Note: Fittings No 3 & 4 to be retained
7/6/58
EB

V.R.
KEW

~~CONVERSION OF STATION BUILDINGS TO~~
~~RESIDENCE~~ -- SITE & SEWERAGE PLAN
SCALE: 40' to 1"

[Signature]
CHIEF CIVIL ENGINEER

DRAWN. <i>[Signature]</i>	CHECKED. <i>[Signature]</i>	CORRES. 10716-52	 SENIOR ARCHITECT
		S. 2220 D. 56	PLAN No. 650-52

